

S/045/0055
Task 6408
cc: Leslie

Application to Revise a Notice of Intention to Commence Small Mining Operations or Exploration

RECEIVED

JAN 20 2015

DIV. OF OIL, GAS & MINING

Operator: <i>Wellman Minerals Corporation</i>			
Mine Name: <i>Brown Rock T / Rocking Chair</i>		File Number: E or S <i>10450055</i>	
Provide a detailed listing of all changes to the Notice that will be required as a result of this change. Individually list all maps and drawings that are to be added, replaced, or removed from the Notice. Include page, section and drawing numbers as part of the description.			
DETAILED SCHEDULE OF CHANGES TO THE NOTICE			
Description of map, text, or materials to be changed			
<input checked="" type="checkbox"/> ADD	<input type="checkbox"/> REPLACE	<input type="checkbox"/> REMOVE	<i>Maps Pages 1 & 2 of 2</i>
<input checked="" type="checkbox"/> ADD	<input type="checkbox"/> REPLACE	<input type="checkbox"/> REMOVE	<i>Exhibit A Page 4 of 4</i>
<input checked="" type="checkbox"/> ADD	<input checked="" type="checkbox"/> REPLACE	<input type="checkbox"/> REMOVE	<i>New Address: 5159 W. Burntside Ave. South Jordan, Utah 84095</i>
<input type="checkbox"/> ADD	<input type="checkbox"/> REPLACE	<input type="checkbox"/> REMOVE	
<input type="checkbox"/> ADD	<input type="checkbox"/> REPLACE	<input type="checkbox"/> REMOVE	
I hereby certify that I am a responsible official of the applicant and that the information contained in this application is true and correct to the best of my information and belief in all respects with the laws of Utah in reference to commitments and obligations, herein.

<i>Gregory R Bennett</i>	<i>Gregory A Bennett</i>
Print Name	Sign Name, Position
	<i>Managing Director</i>
	<i>1-20-15</i>
	Date

Return to:

State of Utah
Division of Oil, Gas and Mining
Attn: Minerals Regulatory Program
1594 West North Temple, Suite 1210
Box 145801
Salt Lake City, Utah 84114-5801
Phone: (801) 538-5291 Fax: (801) 359-3940

P:\GROUPS\MINERALS\WP\FORMS\notices\Draft\MR-REV-SMO-EXP.docx

FOR DOGM USE ONLY:

File #:

Approved:

Bond Adjustment: from (\$)
to \$

Instructions to Revise a Notice of Intention to Commence Small Mining Operations or Exploration

When a Notice of Intention to Commence Small Mining Operations or Exploration (Notice) requires change an Application to Revise a Notice of Intention to Commence Small Mining Operations or Exploration must be submitted. Changes may include Operator address or operational changes. When operational changes are proposed the change may not be implemented until the Division determines that the revised Notice is complete and if necessary a revised reclamation surety approved. The Notice must include all information, concerning the revision, that would have been required if it had been included in the original Notice.

Instructions:

- Changes to the Notice are made by providing a completely new Notice or by adding, replacing, or removing pages to the current Notice. Detailed instructions for adding or replacing pages and maps must be included (please identify on the attached form MR-REV-SMO).
- The revised Notice should be accompanied by a cover letter: referring to the permit number, operator name and mine; content description; and referencing any Division action that initiated the change (i.e. Notice of Violation, previous review, inspection).
- The submitted revision must be complete and should not rely on additional materials that will be submitted at a later date.
- Form MR-REV-SMO, or equivalent, must be submitted with the application for change. After the Division approves the change, a copy will be stamped "approved" and returned to you.

WELLMAN MINERALS CORPORATION

5159 W. Burntside Avenue

South Jordan, Utah 84095

Email: lapstech@gmail.com Telephone: (801) 808-7771

January 10, 2015

State of Utah
Division of Oil, Gas, & Mining (DOGM)
Attn: Leslie Hepler
1594 West North Temple, Suite 1210
Box 145801
Salt Lake City, Utah 84114-5801
Phone: (801) 538-5291

RECEIVED
JAN 20 2015
DIV. OF OIL, GAS & MINING

RE: **WELLMAN MINERALS CORPORATION – File No. SO 45/0055**
Revise NOI (Change of Address) – Form(s) MR-REV-SMO & MR-AR (attached)

Dear Leslie,

As instructed by Form(s) MR-REV-SMO & MR-AR, this submittal includes the referenced cover letter for the appropriate forms attached.

Referenced Form MR-REV-SMO includes the appropriate "Remove" and "Replace" lines addition in order to remove and replace the **address on file**. The previous address was: 10688 S. Indigo Sky Way, South Jordan, Utah 84095. The **new address** is: **5159 W. Burntside Avenue, South Jordan, Utah 84095.**

A copy of the Form MR-AR (Annual Report) is attached because this form is submitted on the same date as the requested "Change of Address."

Thank you for your support and consideration in these matters. We appreciate your help.

Sincerely,



Gregory R. Bennett, Managing Director
WELLMAN MINERALS CORPORATION
5159 W. Burntside Avenue
South Jordan, Utah 84095
(801) 808-7771

WELLMAN MINERALS CORPORATION

5159 W. Burntside Avenue

South Jordan, Utah 84095

Email: lapstech@gmail.com Telephone: (801) 808-7771

January 10, 2015

STATE OF UTAH

Division of Oil, Gas, & Mining (DOGM)

Attn: Leslie Hepler

1594 West North Temple, Suite 1210

Box 145801

Salt Lake City, Utah 84114-5801

Phone: (801) 538-5291

RECEIVED

JAN 20 2015

DIV. OF OIL, GAS & MINING

RE: **WELLMAN MINERALS CORPORATION – UTAH DOGM FILE NO. SO 450055**

(BLM UTU 69198/FILE NO. UTM 181718)

MINE NAME: Rocking Chair/Brown Rock #7

Amendment/Revision to Notice of Intention

(Small Mining Operation/Explorations)

Dear Leslie Hepler,

Please accept this cover letter (and enclosures) as our formal request to amend/revise the existing approved **NOI** on file.

*This request includes **an amendment/revision** to the existing approved **Reclamation (disturbance) Area** within the Rocking Chair/Brown Rock #7 Mining Claim. The reclamation surety bond presently in place covers a One (1) Acre disturbance area. The proposed (and requested) revision shall also be confined within a One (1) Acre disturbance area. (Please refer to the enclosed area maps.)*

Amended/Revised Area of Disturbance (detail):

The present **NOI** on file claims an (rectangular) area 150 ft. Wide X 290 ft. Long – **One Acre**.

This request proposes to trade the (northern portion of the approved on-file area ; or area directly “above” the wash area) of the existing approved area for the two sections (as shown on the map(s) immediately to the west and east of the southern portion of the approved area – totaling **One Acre**.

The amended/revised area will then include:

- a) "Southern Portion (including the wash) of the existing approved area – 25,875 square feet.
- b) Western attached area (as shown – which includes the existing well and fenced area with additional 10 ft. borders on all sides – 3,500 square feet.
- c) Eastern attached area (as shown – which includes additional overburden area(s) – 14,000 square feet.

The approximate total square footage of the three area indicated above are: 43,375 (with allowances to extend to the entire one-acre footage area.


Additional Reclamation Bond increase: (As previously agreed)

The increase of Reclamation Bond (to the present Bond on file), as previously agreed, is in our understanding a total of \$1,500 for the amended/revised area. This increase is to cover the extended responsibility of reclamation to the existing (shallow depth) well located within the proposed 3,500 square foot area. Please provide details for our posting of this increased amount.

We appreciate your help and consideration in approved this proposed/requested amendment/revision to our **NOI**. Thank you for your support in this matter.

If there are any further questions, please contact me at your earliest convenience.

Sincerely,

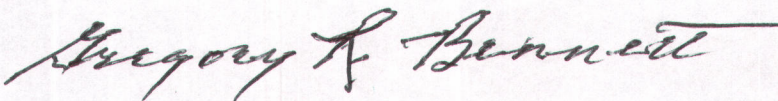


Gregory R. Bennett, Managing Director
Wellman Minerals Corporation
5159 W. Burntside Avenue
South Jordan, Utah 84095
(801) 808-7771

REVISED/AMENDED ONE-ACRE AREA DISTURBANCE
(See July 21, 2014 Letter; item #1)

T8S R18W
SECTION 11

BLM U-69198 (UTAH DOGM FILE# S0450055)

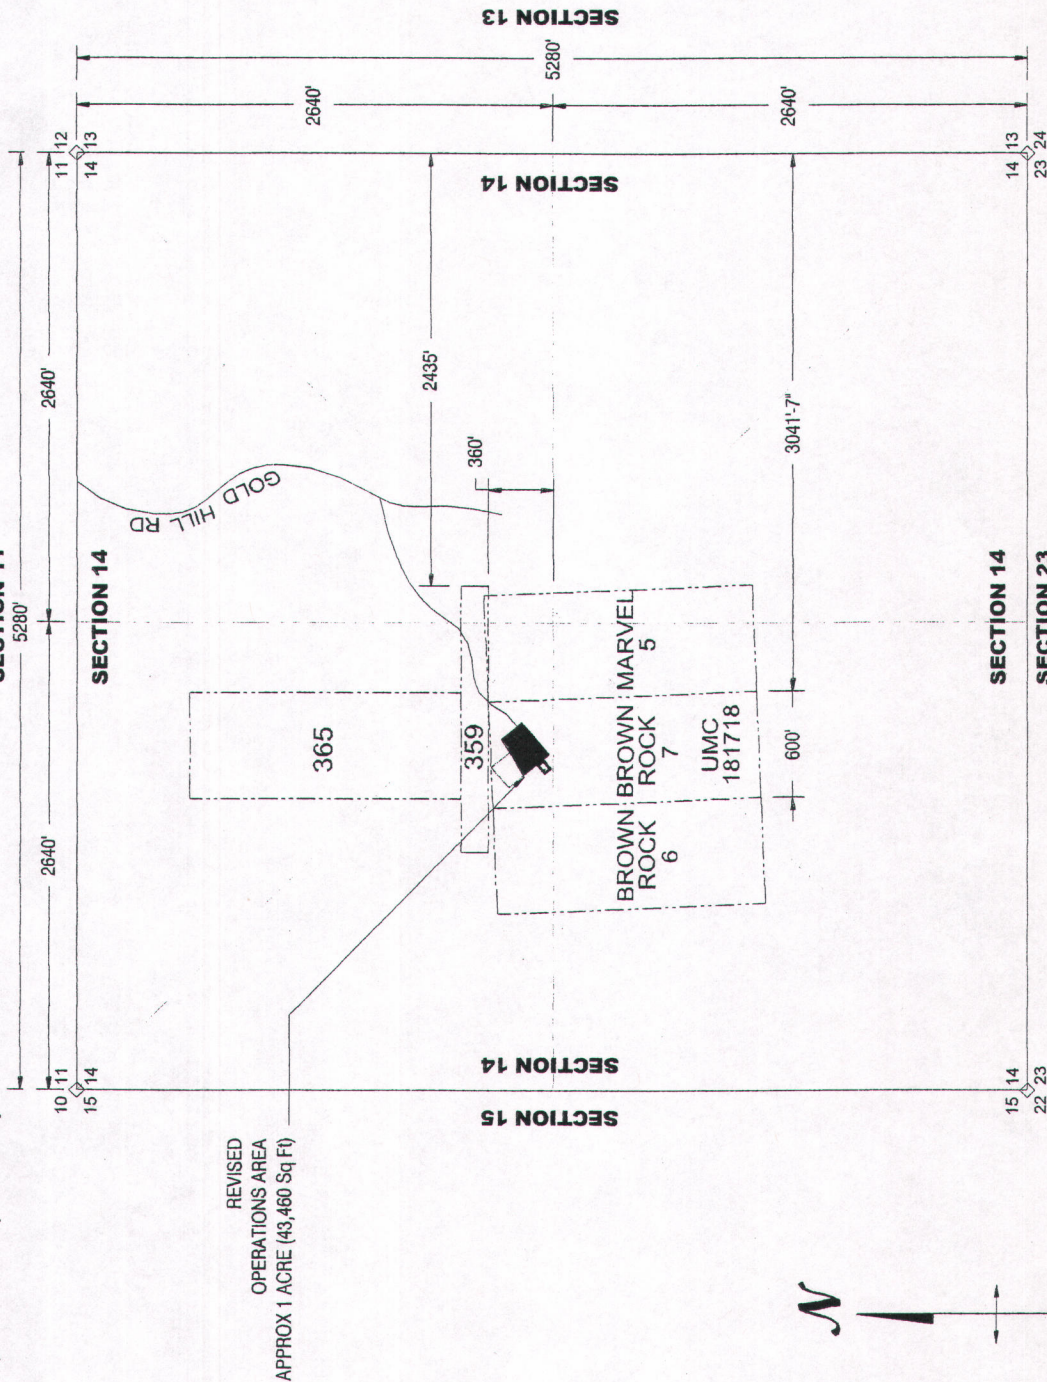

ISB, LLC
Integrated Systems by Bennett
Consulting • Engineering • Design • Equipment • Sales
"The Right Choice"

TITLE: Plan of Operations
General Location Map
Revised Area

JOB: Wellman Minerals Corp.
(A&B Technologies, LLC)

1323 W. Natasha Circle • Riverton, UT 84065
Phone: (801) 446-9514 • Fax: (801) 446-9550

DRAWN: RTB
CKD:

DATE:
APPROVED:

REV: JULY 21, 2014
SCALE: NONE

JOB NO: UTU-69198


1-14-12
Page: 1 of 2

1-10-13

Page: 2 of 2

REVISED/AMENDED ONE-ACRE AREA DISTURBANCE
(See July 21, 2014 Letter; item #1)

BLM U-69198 (UTAH DOGM FILE# S0450055)

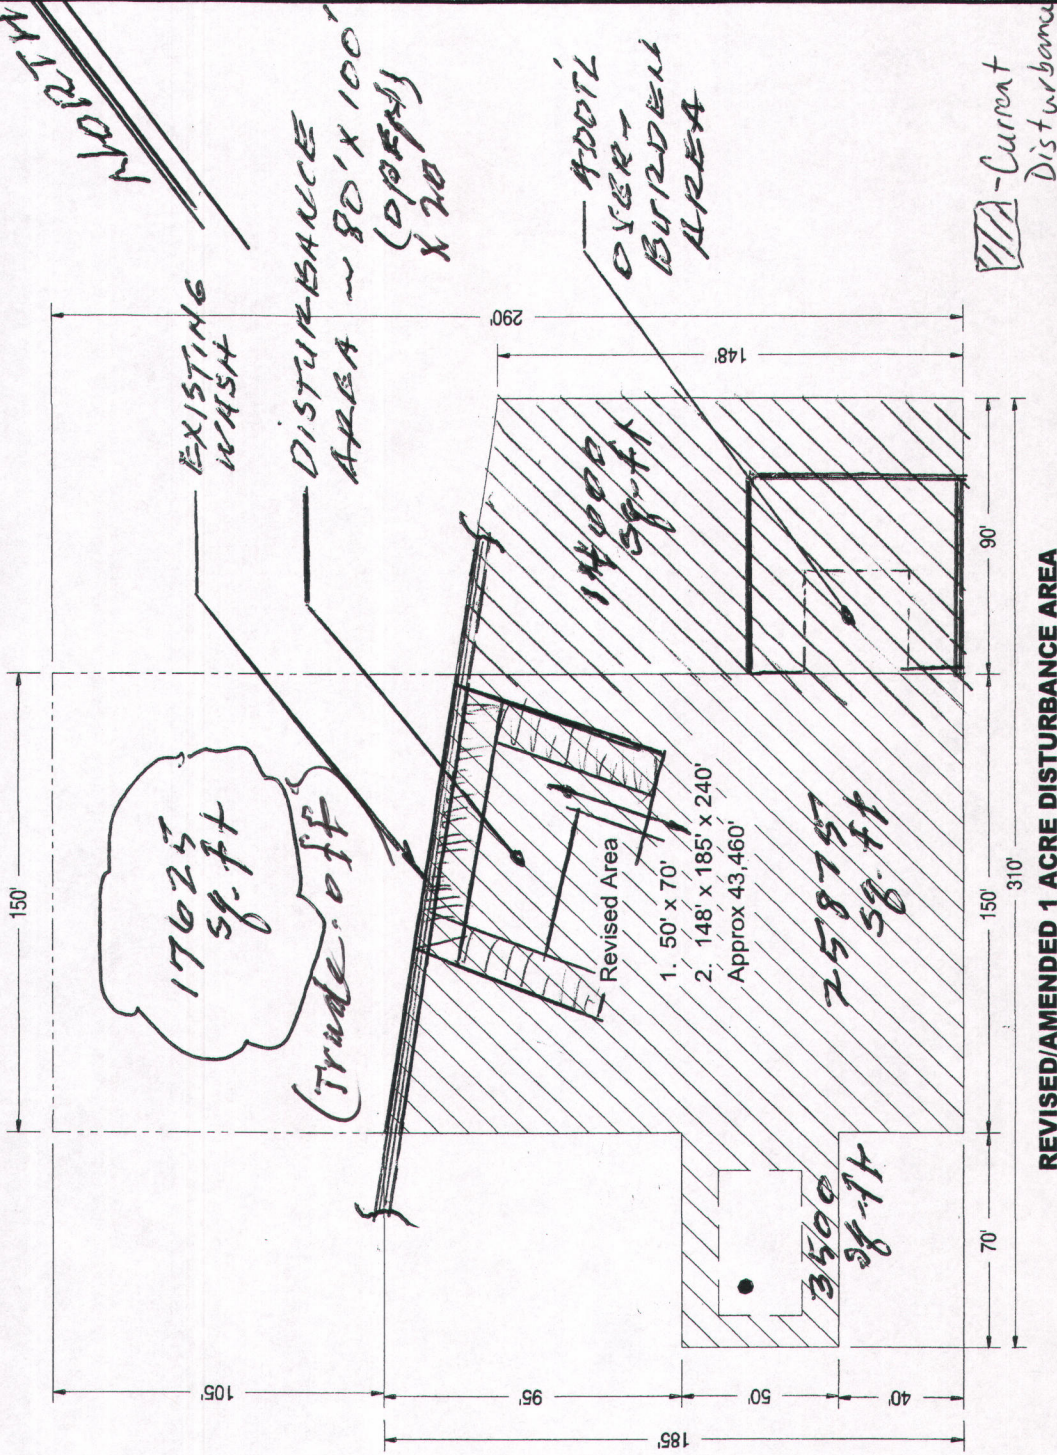

REVISED/AMENDED 1 ACRE DISTURBANCE AREA

REV.
TOTAL 43,375
sq.-ft.

1 Acre

isb ISB, LLC Integrated Systems by Bennett Consulting • Engineering/Design • Environmental • Sales "The Right Choice"		TITLE: Plan of Operations Revised Area		JOB: Wellman Minerals Corp. (A&B Technologies, LLC)	
DRAWN: RTB	DATE:	APPROVED:	SCALE: NONE	REV: JULY 21, 2014	JOB NO: UTU-69198 -A
1323 W. Alachua Circle • Riverton, UT 84085 Phone: (801) 446-9314 • Fax: (801) 446-9350					

Exhibit A

Recording Data

Claims Name	Book	Page	Entry #	UMC #
Flat 400	220	851	362468	278032
Flat 401	220	852	362469	278033
Flat 404	220	855	362472	278036
Flat 405	220	856	362473	278037
Flat 359	191	985	344553	238255
Flat 365	191	991	344559	238261
Barium Lode 5	176	140	333766	130835
Marvel 5 (Amended)	36/92	3/560	263079/289398	181727
Brown Rock 6 (Amended)	20/92	236/573	255265/289402	181717
Brown Rock 7 (Amended)	20/92	237/574	255266/289403	181718

REC.
AREA
CLAIM

Note: The ten (10) lode claims (listed above) are registered and properly established mineral claims to certain property and legal rights. These claims are registered in the name of Wellman Minerals Corporation in Tooele, County, State of Utah. Established ownership by Wellman Minerals Corporation as allowed by federal law of the United States of America.